

ROCK HILL OFFICE:
York County Office Complex
1070 HeeRie Blvd., A-5
Rock Hill, S.C. 29730
Phone: 803-327-9079
S.C. STATS 800-922-7271

BUILDING PERMIT APPLICATION

Complete York County, S. C.

YORK OFFICE:
Congress Street
P.O. Box 725
York, S.C. 29745
Phone: 803-684-8503

D-1

PERMIT # *49046*

JOB ADDRESS
3338 WILLOWOOD DR. ROCK HILL SC

1	LEGAL DESCR.	LOT NO. 6	BLK 2	TRACT ACREAGE	SUB-DIVISION WILLOWOOD	HIGHWAY NO.
2	OWNER	JACKIE & SHIRLEY LEAR	MAIL ADDRESS	2849 LESSLIE DALE RD	ZIP ROCK HILL SC	PHONE 324-4937
3	CONTRACTOR	SAME AS OWNER	MAIL ADDRESS		PHONE	LICENSE NO.
4	ARCHITECT OR ENGINEER	NA	MAIL ADDRESS		PHONE	LICENSE NO.
5	TAX DISTRICT	TAX MAP BLOCK NO. 750-33	SCHOOL DIST.	3		
6	USE OF BLDG.	☒ SINGLE FAMILY RESIDENTIAL	☐ DUPLEX	☐ APT.	☐ COMMERCIAL	☐ INST. ☐ WAREHOUSE
7	☐ MANUFACTURING	☐ UTILITY	☐ OTHER DESCRIBE:			
8	CLASS OF WORK	☒ NEW	☐ ADDITION	☐ ALTERATION	☐ REPAIR	☐ MOVE ☐ DEMOLISH
9	BRIEF DESCRIPTION	SINGLE FAMILY DWELLING RESIDENTIAL				
10	TYPE OF CONST.	☒ FRAME ☐ METAL ☐ WOOD ☐ OTHER EXPLAIN: TYPE VI UNPROTECTED				
11	TYPE OF EXTERIOR	☐ BRICK	☐ BLOCK	☐ STONE	☒ BRICK VENEER	☐ STUCCO ☐ METAL ☐ WOOD
12	SQ. FT.	2213	VALUATION OF WORK	\$73,967.00	PERMIT FEE	\$208.00
13	ESTIMATED DATE OF COMPLETION	3-1-91	POWER COMPANY	DUKE POWER	<i>NOT BUILT NB 1-30-91</i>	
14	GENERAL INFORMATION	NO. OF STORIES 1	NO. OF BEDROOMS 3	NO. OF BATHS 2	FIREPLACES 1	GARAGE 1 CARPORT
	TYPE OF HEAT	GAS	FUEL	CENTRAL AIR	NEED XXXX APPROVAL ON SEPTIC TANK BEFORE ISSUING CO	
ALL WORK TO COMPLY WITH THE 1988 STANDARD BUILDING CODE 1989 REVISIONS. 1990 NATIONAL ELECTRICAL CODE						

NOTICE

THIS PERMIT BECOMES NULL AND VOID IF WORK OR CONSTRUCTION AUTHORIZED IS NOT COMMENCED WITHIN 6 MONTHS, OR IF CONSTRUCTION OR WORK IS SUSPENDED OR ABANDONED FOR A PERIOD OF 1 YEAR AT ANY TIME AFTER WORK IS COMMENCED.

I HEREBY CERTIFY THAT I HAVE READ AND EXAMINED THIS APPLICATION AND KNOW THE SAME TO BE TRUE AND CORRECT. ALL PROVISIONS OF LAWS AND ORDINANCES GOVERNING THIS TYPE OF WORK WILL BE COMPLIED WITH WHETHER SPECIFIED HEREIN OR NOT. THE GRANTING OF A PERMIT DOES NOT PRESUME TO GIVE AUTHORITY TO VIOLATE OR CANCEL THE PROVISIONS OF ANY OTHER STATE OR LOCAL LAW REGULATING CONSTRUCTION OR THE PERFORMANCE OF CONSTRUCTION.

NB. APP GAS TEST 4-18-91

NOTICE TO OWNER OR POSSESSOR

Pursuant to S.C. Code Sec. 15-3-640 you have the right to contract for a guarantee of the structure being free from defective or unsafe conditions beyond thirteen years after substantial completion of the improvement for which the permit is issued.

APP. GARAGE SLAB 12-13-90 OK

SIGNATURE OF OWNER OR CONTRACTOR

DATE

ISSUED BY

* CHECK FOR GASES PLATES IN AREA OF SERVICE EQUIPMENT BOTTOM PLATE
FIRE PLATE NOT BUILT. 1-22-91
Complete 12-9-91

FIRE ZONE	USE ZONE	FIRE SPRINKLER REQ: YES NO	
NO. OF DWELLING UNITS	OFF STREET PARKING SPACES COVERED UNCOVERED		
SPECIAL APPROVALS	REQUIRED	APP	NOT REQUIRED
ZONING	XX	XX	
HEALTH DEPT.	XX		
FIRE DEPT.			
SOIL REPORT			
OTHER: SPECIFY			
INSPECTIONS			
GIVE DATE	APPROVED	DISAPPROVED	DATE
FOUNDATION	<i>NB</i>		11-27-90
FRAMING	<i>NB</i>		1-22-91
R. ELECTRIC	<i>NB</i> *		1-22-91
R. PLUMBING	<i>NB</i>		1-22-91
TEMP. POWER	<i>NB</i>		4-18-91
C. O.	<i>CA</i>	<i>NB 4-18-91</i>	10-9-91

① S. DETON IN HALLWAY

② GAS WATER HEATER IN STORAGE ~~ROOM~~ OF UNCONTAINED SPACE

near the top of the wall

YORK COUNTY ZONING RESIDENTIAL COMPLIANCE PERMIT

A. TYPE OF COMPLIANCE PERMIT:
PERMANENT TEMPORARY

B. OWNER NAME Lear
C. TAX MAP# 750-33
D. Permit # _____

E. CLASS OF WORK:

SINGLE FAMILY DWELLING
MOBILE HOME
MODULAR HOME
STORAGE BLDG.
DETACHED GARAGE
ATTACHED GARAGE
BLDG. ADDITION
SWIMMING POOL
AGRICULTURAL BLDG.


SQUARE FEET

F. ZONING CLASSIFICATION RDI

G. SET BACK REQUIREMENTS

REAR PROPERTY LINE

LEFT SIDE
PROPERTY LINE

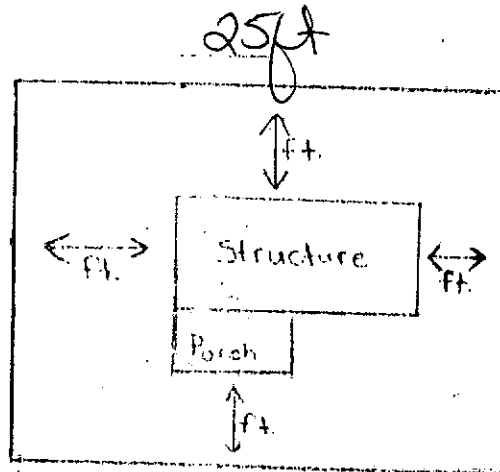

RIGHT SIDE
PROPERTY LINE

ROAD RIGHT OF WAY

H. OTHER STRUCTURES ON PROPERTY None

I. DISTANCE BETWEEN MAIN STRUCTURES N/A

APPLICANT ACKNOWLEDGEMENT: I DO ACKNOWLEDGE THAT THE ABOVE INFORMATION IS TRUE, AND DO AGREE TO COMPLY WITH ALL REQUIREMENTS OF THE YORK COUNTY ZONING AND DEVELOPMENT STANDARDS ORDINANCE.

SIGNATURE: [Signature] DATE: _____ TELEPHONE: 384 3040

ZONING OFFICIAL Cain J. Moss DATE: 9/24/96



3574 263
 AUG 23 2 11 PM '77
 THAD L. CARROLL
 C.E.C. & S.C.
 YORK COUNTY, N.Y.

M H CARROLL

M. H. CARROLL

SITE LOCATION MAP
N.T.S.

SITE

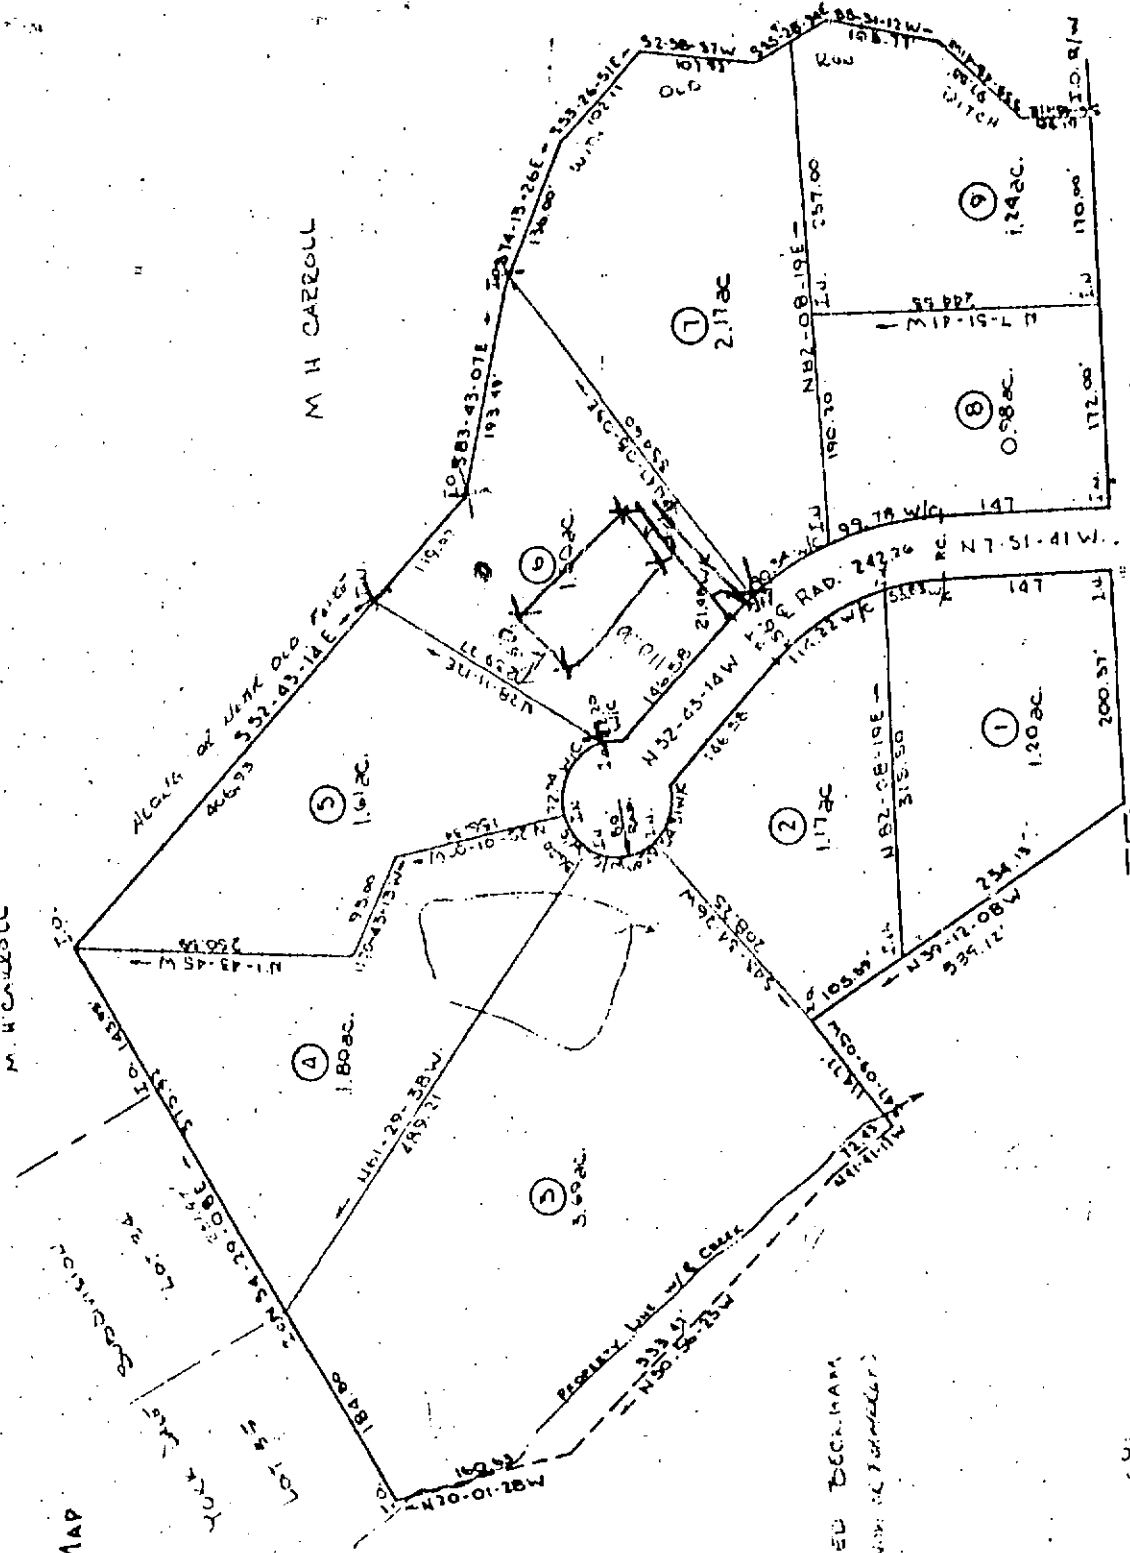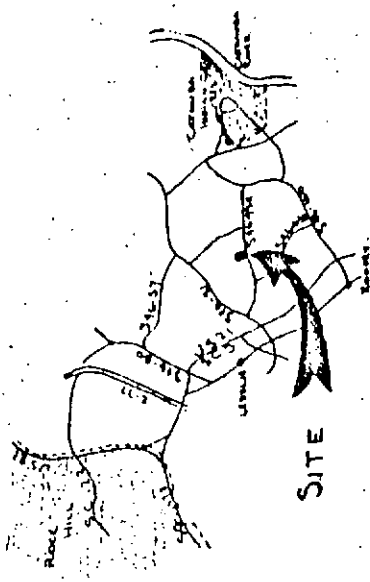

NOTES:

1) BOUNDARY SURVEY BY B.M. HUGHES, R.L.S.,
 JULY 29, 1977

SOUTH CAROLINA DEPARTMENT OF HEALTH AND ENVIRONMENTAL CONTROL
PERMIT TO CONSTRUCT - CERTIFICATE OF FINAL APPROVAL
INDIVIDUAL SEWAGE TREATMENT AND DISPOSAL SYSTEM

Permit No. 14764 Type Facility 3 Bedroom House System Category 360
 Name Shirley & Jackie Lean Mailing Address 2849 Sessledale Rd. R.H. SC. 29739
 Subdevelopment Willowwood Street Willow Pond Rd Block _____ Lot 6 Type Water Supply Private

SYSTEM SPECIFICATIONS

Max. Est. Daily Flow 360 gpd
 Loading Rate 4
 Tank Size(s) 1000 gal

Trenches: Length 300'
 Width 3'
 Max. Depth 3'
 Stone Depth 14"

Min. Pump Capacity NA gpm
 at _____ ft. of Head

SPECIAL INSTRUCTIONS/CONDITIONS

Keep on Contour


use elbows

Keep 50' From well

MAX Depth 36"

Do not drive on Drain Field

SKETCH OF RECOMMENDED INSTALLATION

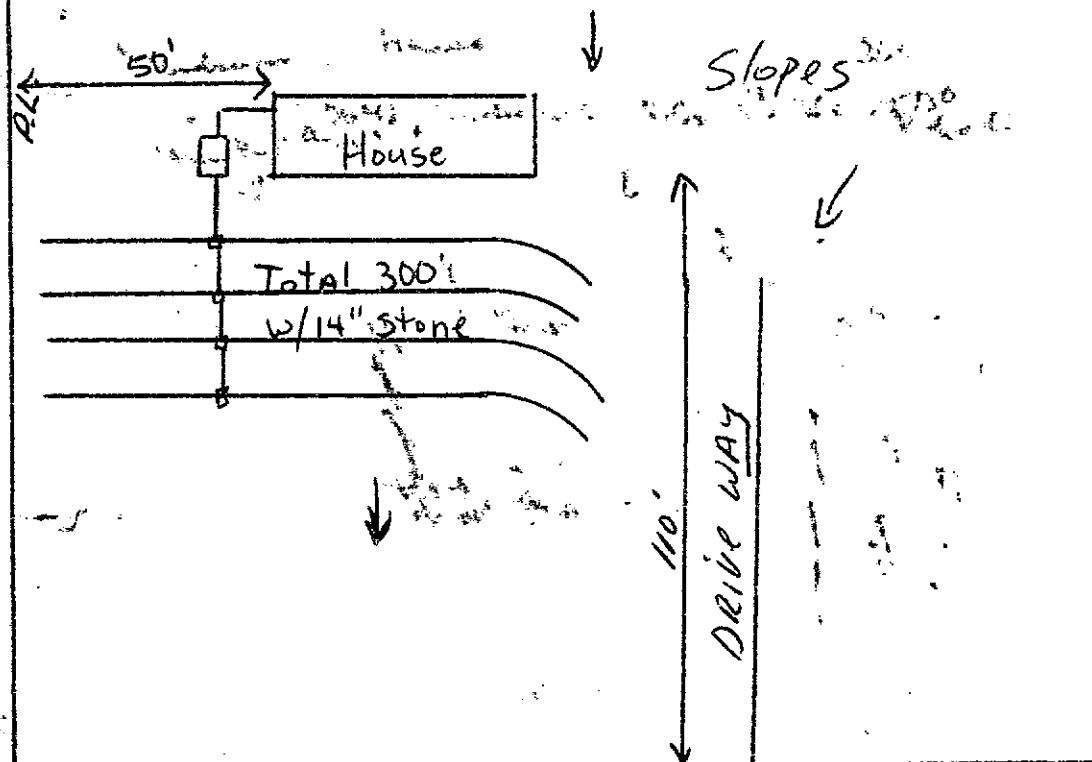

Willowwood Pond Road

ACTUAL INSTALLATION

Installer _____

Tank(s) Mfg. _____

Pipe Mfg. _____

Well Installed _____ Yes _____ No _____

Nearest Actual Distances from System to:

Well _____

Foundation _____

Property Line _____

Impoundment _____

Stream _____

Line No. Grade Readings

SKETCH OF ACTUAL INSTALLATION

THIS CERTIFICATE OF FINAL APPROVAL IN NO WAY GUARANTEES THE LIFE OF THE SYSTEM OR THAT IT WILL FUNCTION PROPERLY UNDER ANY OR ALL CONDITIONS.

Issued By: Bill Hannon Date: 9/25/90 Approved By: _____ Date: _____

APR BY RK 4.27.97